



TOWN OF EASTHAM
BUILDING DEPARTMENT
 2500 STATE HIGHWAY
 EASTHAM, MA 02642
 508-240-5900 Ext. 202
 508-240-5918 Fax

Permit #: _____
 Date Issued: _____
 Fee Rec'd.: _____
 Approved: _____

EXPRESS PERMIT

1. Property Location 175 MEETINGHOUSE ROAD MAP 9 PARCEL 149
2. Owner DEBBIE COHEN 3. Phone 508 240 5900 4. Email BUILDING@DEPT.P.EASTHAM-MA.GOV
5. Owner Mailing Address: 2500 STATE HIGHWAY, EASTHAM, MA 02642
6. Lot Description: Lot Area _____ Frontage _____ Zoning _____
7. Setbacks: Front _____ Left _____ Right _____ Rear _____
8. Estimated Construction Cost \$5,000.- 9. Estimated Completion Date: FALL 2020
10. Are you within 100' of a wetland (Y or N): N

PROJECT INFORMATION:

- Project Type: Roofing Siding Wood Stove Insulation Tent
- Windows: U-Value _____ Doors: U-Value _____
- Storage Structure \leq 200 sq. ft. (Zoning) Other _____

Description of Proposed Work, Materials and Dimensions: _____
8' x 10' STORAGE SHED

Debris Disposal:

Debris resulting from this project shall be disposed of at EASTHAM TRANSFER STATION
 which is a properly licensed solid waste disposal facility as required by MGL Chapter C-111, Section 150A.

Authorization Information:

Owners Signature: _____ Date: 12/1/2020
A separate letter from the owner with the above information is acceptable

Contractor/Agent Name: N/A HIC # _____ CSL # _____

Address: _____ Phone: _____ Email: _____

Please complete the Massachusetts Workers' Compensation Insurance Affidavit on the back of this application.

Inspections: Foundation Frame Other: _____ Final



TOWN OF EASTHAM

2500 State Highway, Eastham, MA 02642-2544
All departments 508-240-5900 • Fax 508-240-1291
www.eastham-ma.gov

HOMEOWNERS' EXEMPTION ELIGIBILITY AFFIDAVIT

I, DEBBIE WATSON (full legal name), born 12/14/1986 (month, day, year), hereby depose and state the following:

1. I am seeking a building permit pursuant to the homeowners' exemption to the permit requirements of the Massachusetts State Building Code, codified at 780 CMR 110.R5.1.3.1, in connection with a project or work on a parcel of land to which I hold legal title.
2. I am not engaged in, and the project or work for which I am seeking the aforementioned homeowners' exemption, does not involve the field erection of manufactured buildings constructed in accordance with 780 CMR 110.R3.
3. I qualify under the State Building Code's definition of "homeowner" as defined at 780 CMR 110.R5.1.2:

Person(s) who owns a parcel of land on which he/she resides or intends to reside, on which there is, or is intended to be, a one-or two-family dwelling, attached or detached structures accessory to such use and/or farm structures. A person who constructs more than one home in a two-year period shall not be considered a home owner.
4. I do not hold a valid Massachusetts construction supervision license and, except to the extent that I qualify for and will abide by the Massachusetts State Building Code's requirements for the supervision of the project or work on my parcel, I am not engaged in construction supervision in connection with any project or work involving construction, reconstruction, alteration, repair, removal or demolition involving any activity regulated by any provision of the Massachusetts State Building Code.
5. If I engage any other person or persons for hire in connection with the aforementioned project or work on my parcel, I acknowledge that I am required to and will act as the supervisor for said project or work.


Signed under the pains and penalties of perjury on this 1 day of DECEMBER, 2020.

Debbie Watson

9-149

SITE PLAN

1" = 20'

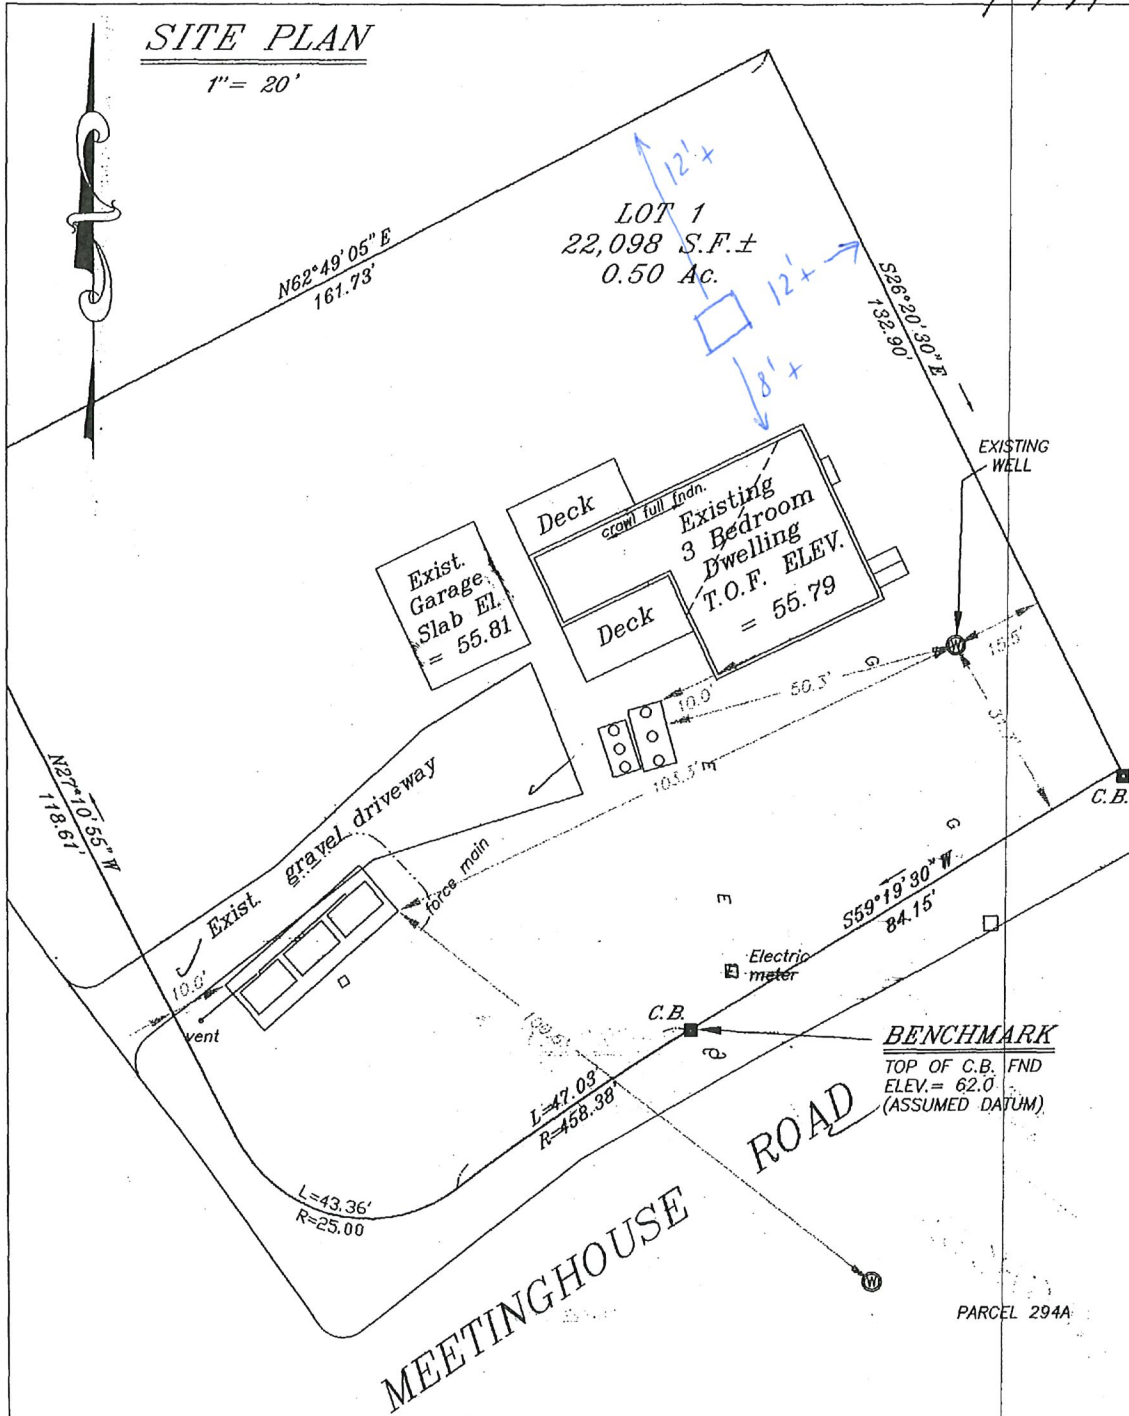


AS-BUILT ON-SITE SEWAGE TREATMENT AND DISPOSAL SYSTEM

Prepared for: JOHN J. AND CAROLE A. MURPHY
Location: 175 MEETINGHOUSE ROAD, EASTHAM, MASS.

Ryder & Wilcox, Inc., P.E. & P.L.S.
3 Ciddiah Hill Rd.
P.O. Box 439
So. Orleans, MA, 02662
Tel. (508) 255-8312
Fax. (508) 240-2306

Scale: 1" = 20'
Drawn by JAP
Date - March 17, 2004

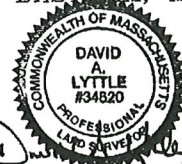

Job No. 9090